


RECEPTACLE STUB-UP DETAIL
NO SCALE

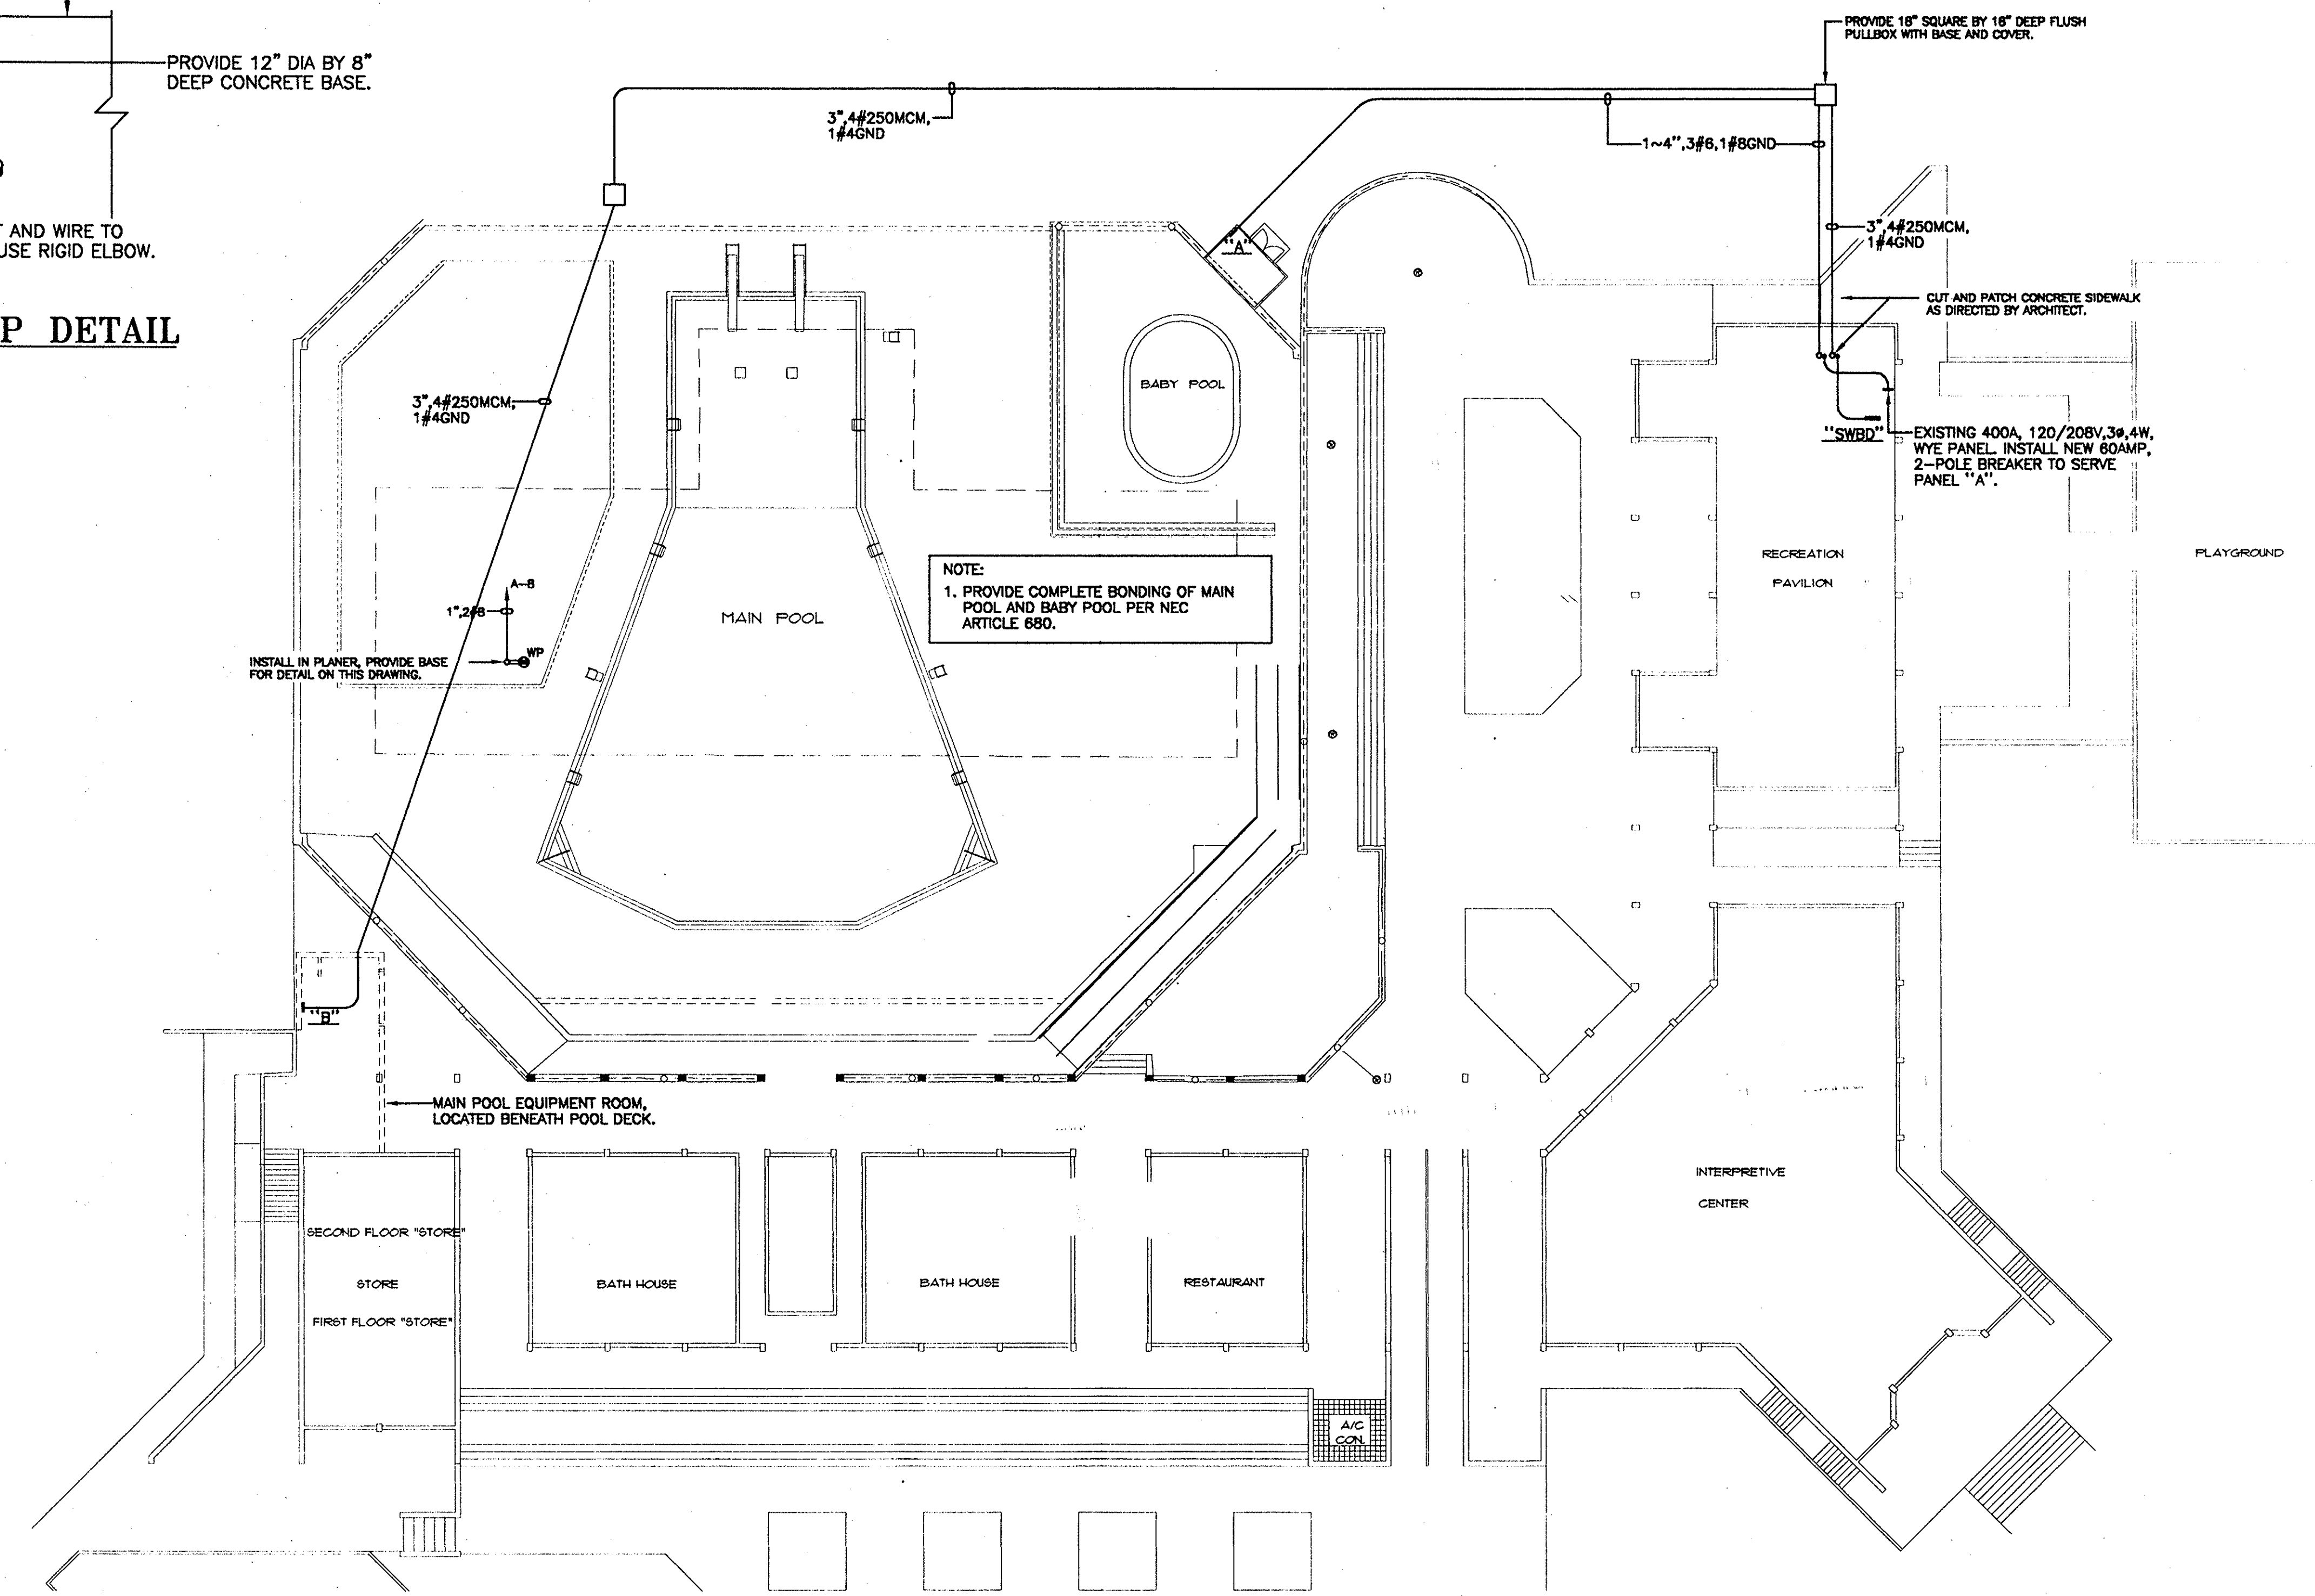

SITE PLAN - ELECTRICAL
SCALE: 1"=20'-0"

AS BUILT

DISTRIBUTION RECORD:		REVISION RECORD:	
ISSUED TO:	QUANTITY:	DATE:	DESCRIPTION:

planning
associates, inc.
architects

1112 MCALLIE AVENUE
CHATTANOOGA, TN. 37404

423-622-5121

REPLACE SWIMMING POOL
NORRIS DAM STATE PARK
LAKE CITY, TENNESSEE
SBC # 126/063-01-97A

DATE: 10/04/00
JOB #: 371
SHEET #:
E-1