



1-METER DECK LEVEL DIVING STAND W/ RAILS

SCALE: 1/2"=1'-0"

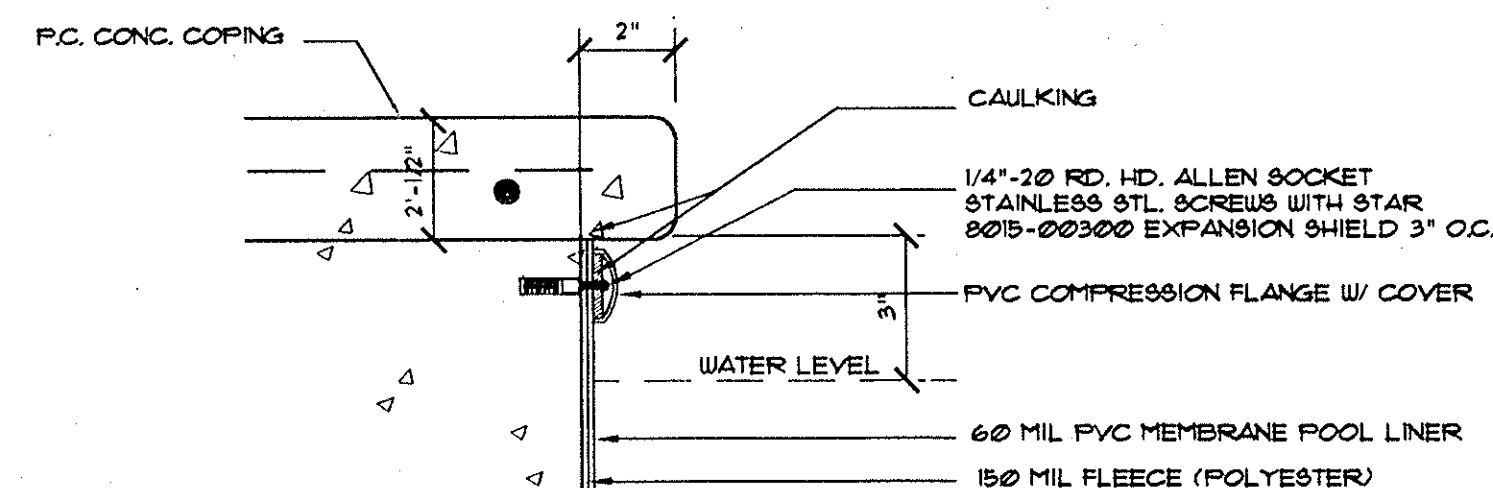


BABY POOL LINER DETAIL

SCALE: 3/4"=1'-0"

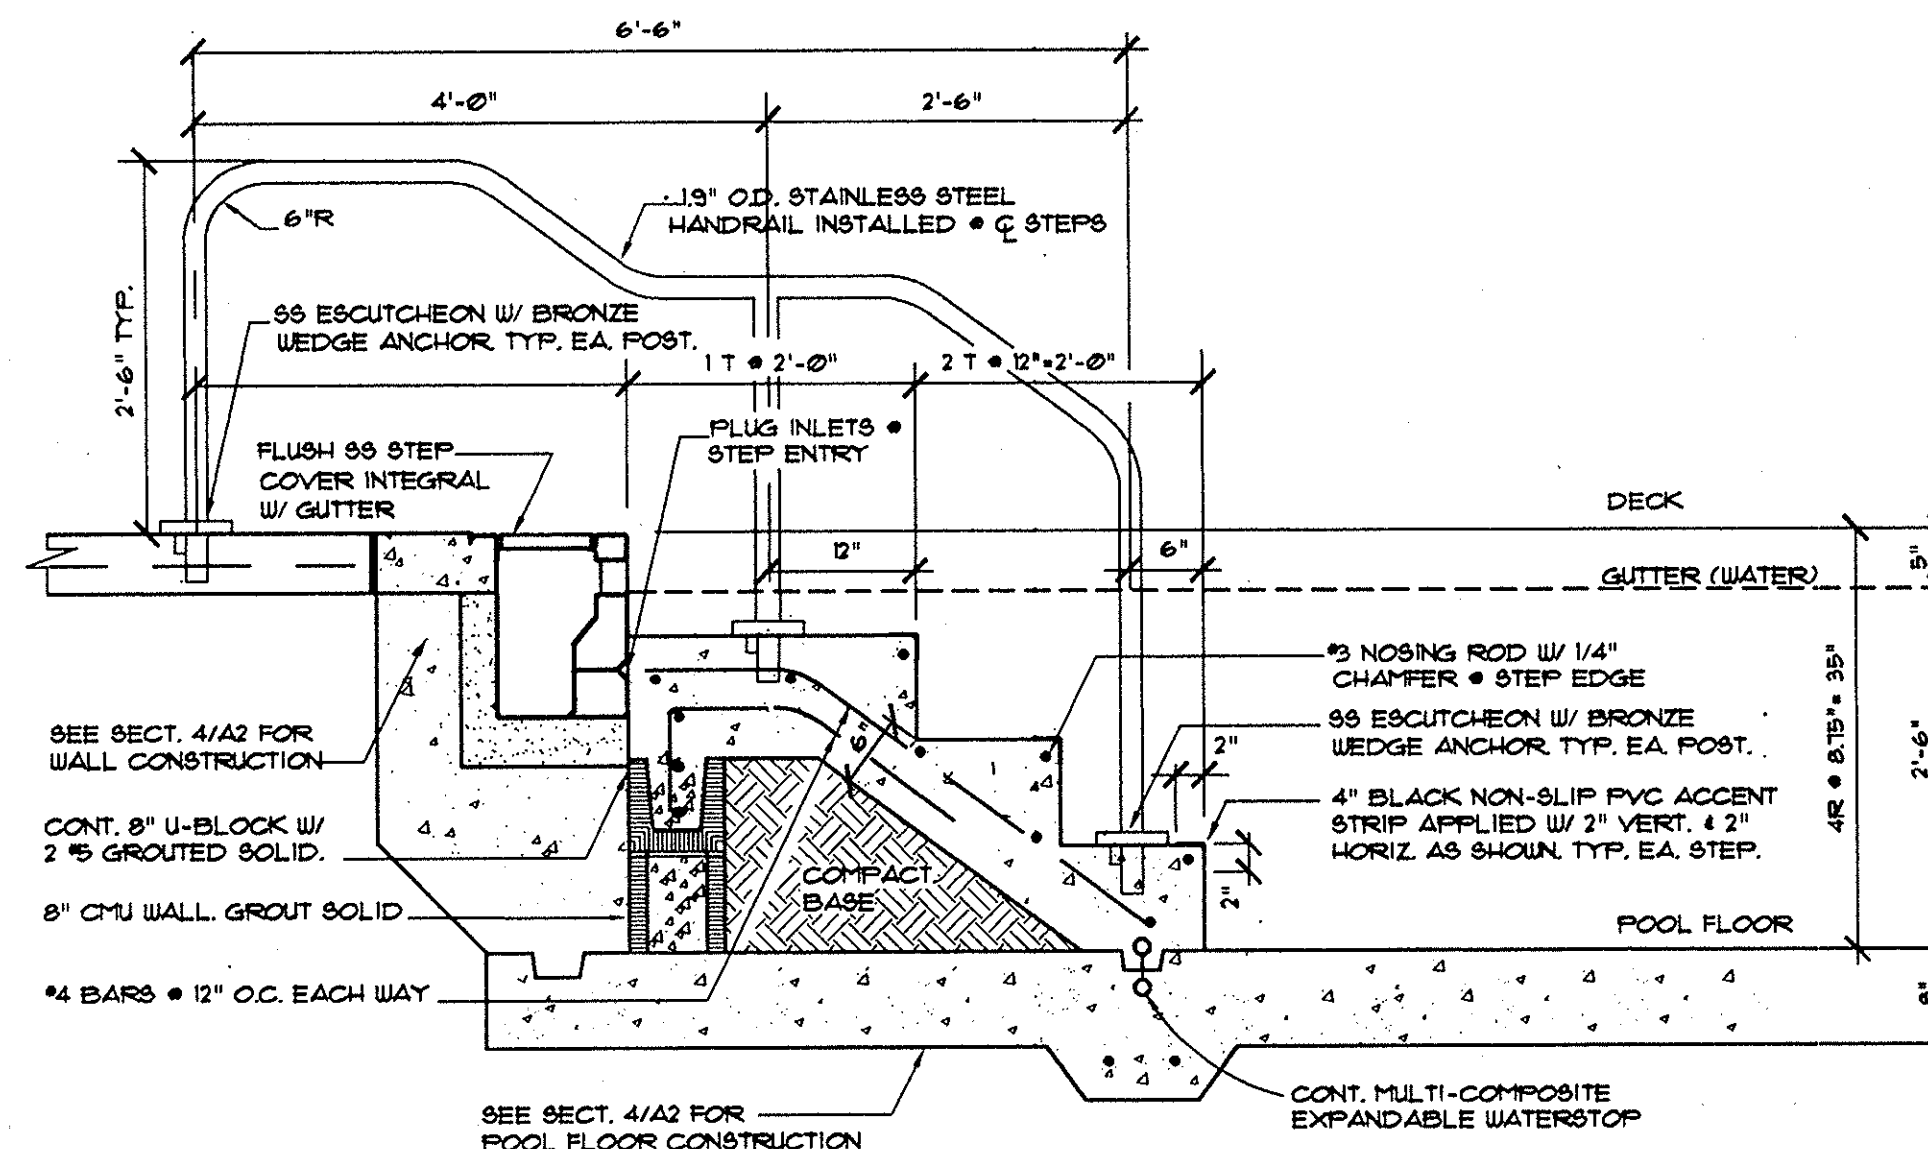


POOL STAIR & HANDRAIL SECTION

SCALE: 3/4"=1'-0"

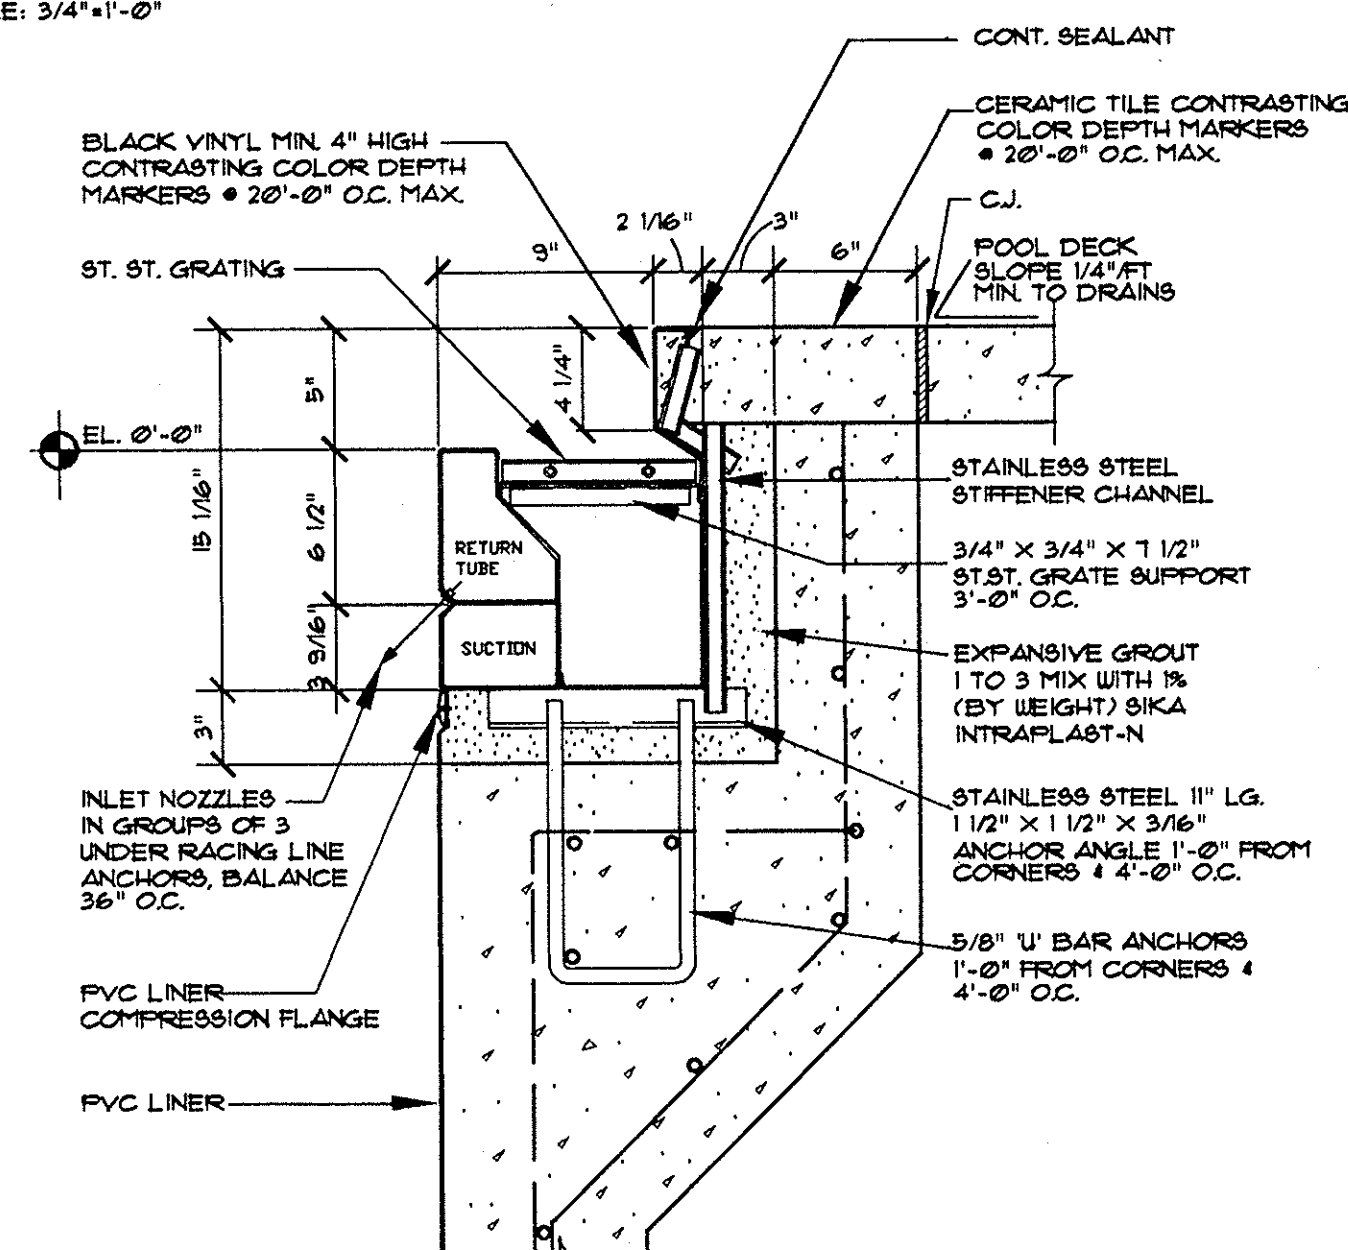


MAIN POOL WALL SECTION

NOTE: LOW CARBON TYPE 304 STAINLESS STEEL IFRS-A5R SYSTEM I
NOTE: FOR LOWER MAIN POOL WALL REINFORCING & DETAILS SEE SECTION 4/A2.

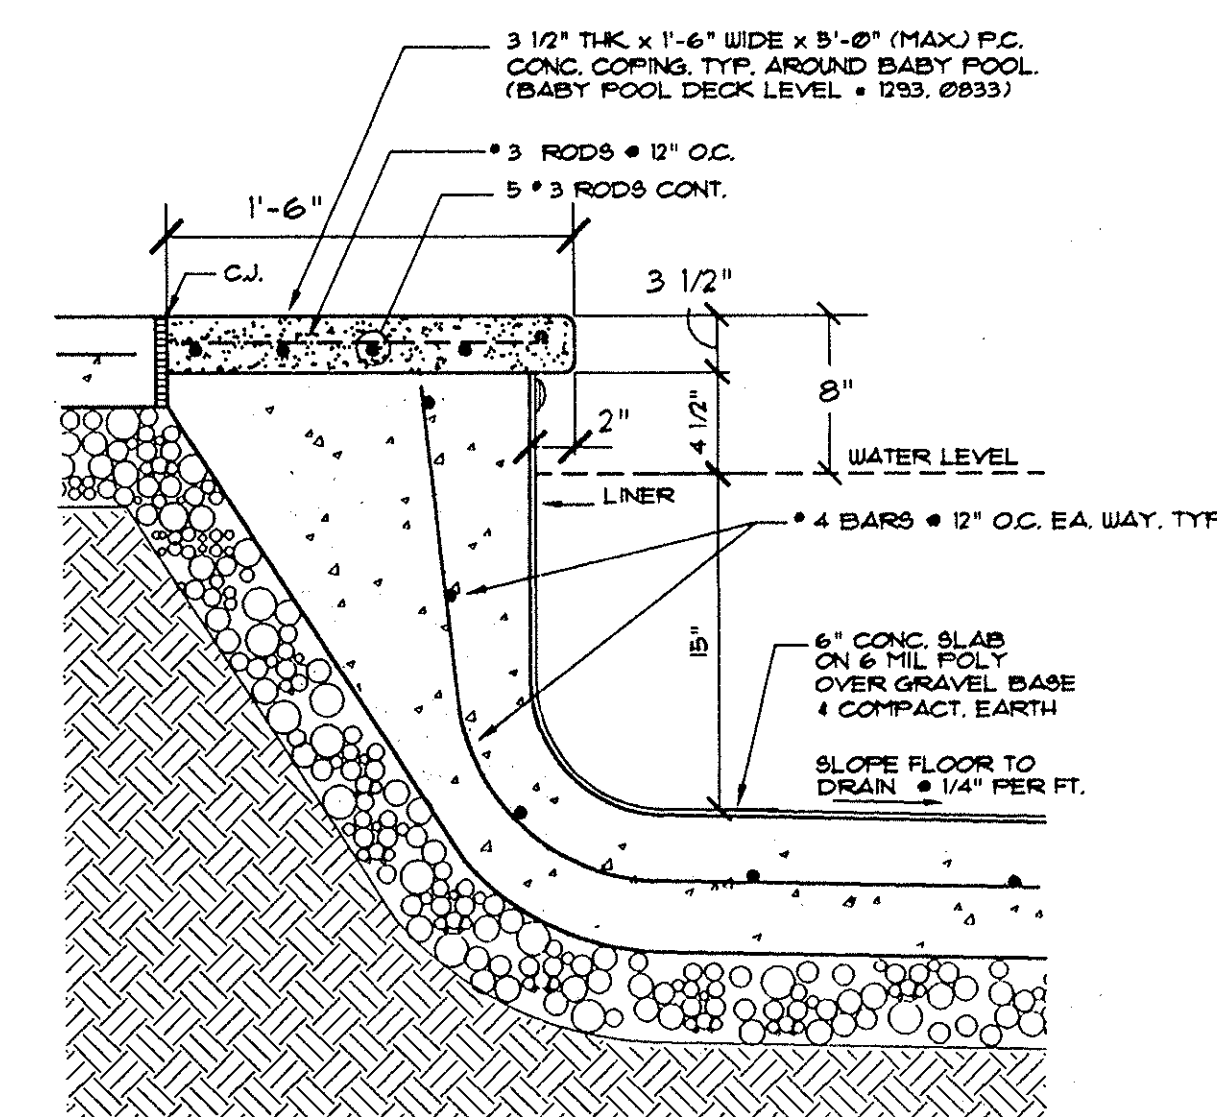


BABY POOL WALL SECTION

NTS.

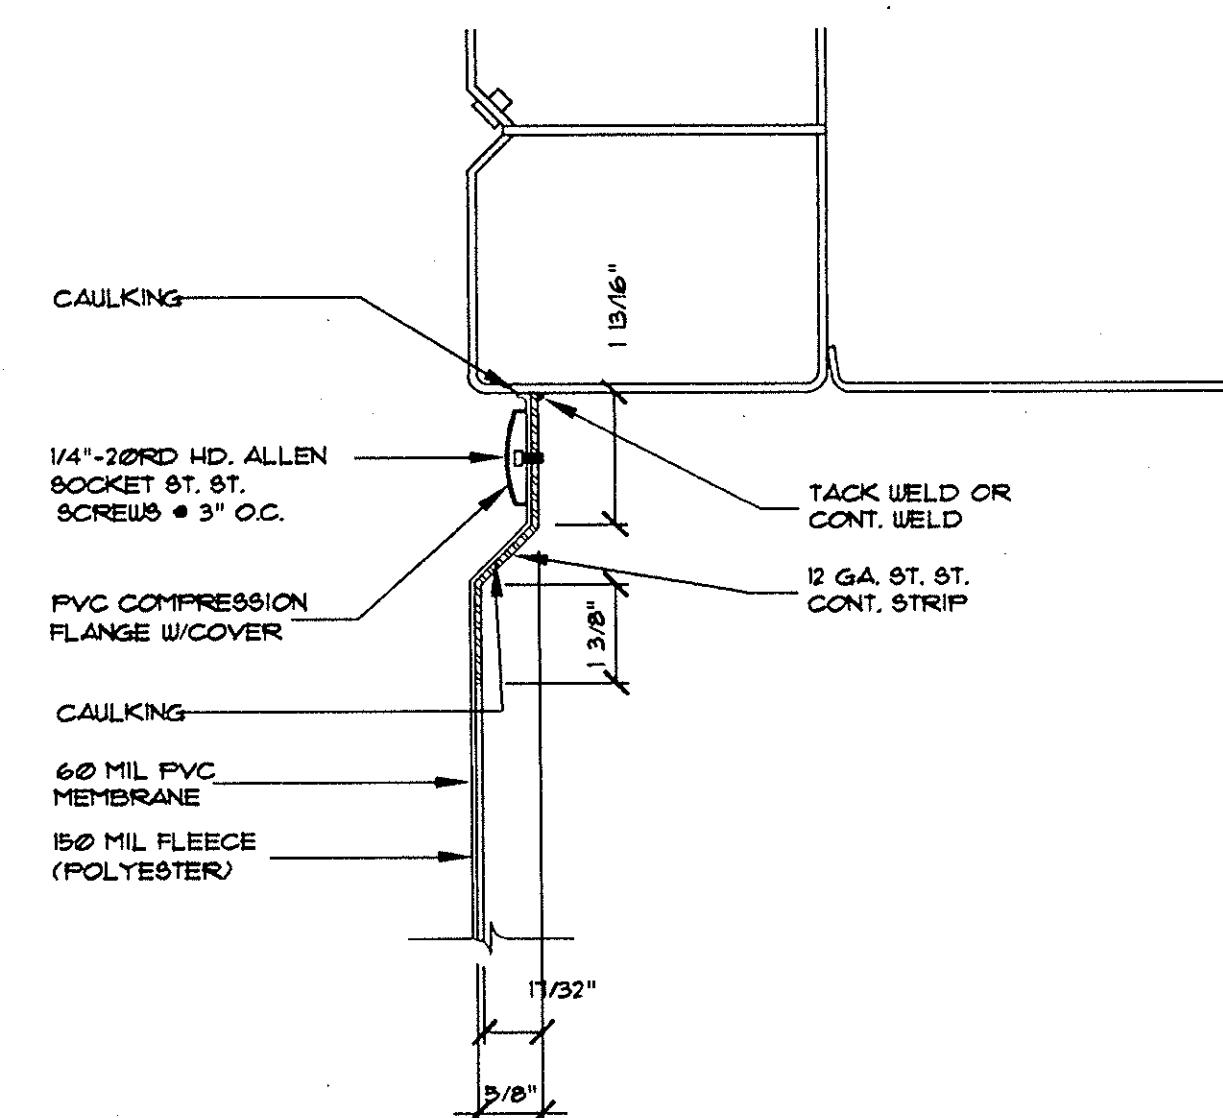

MAIN POOL LINER DETAIL

NTS.

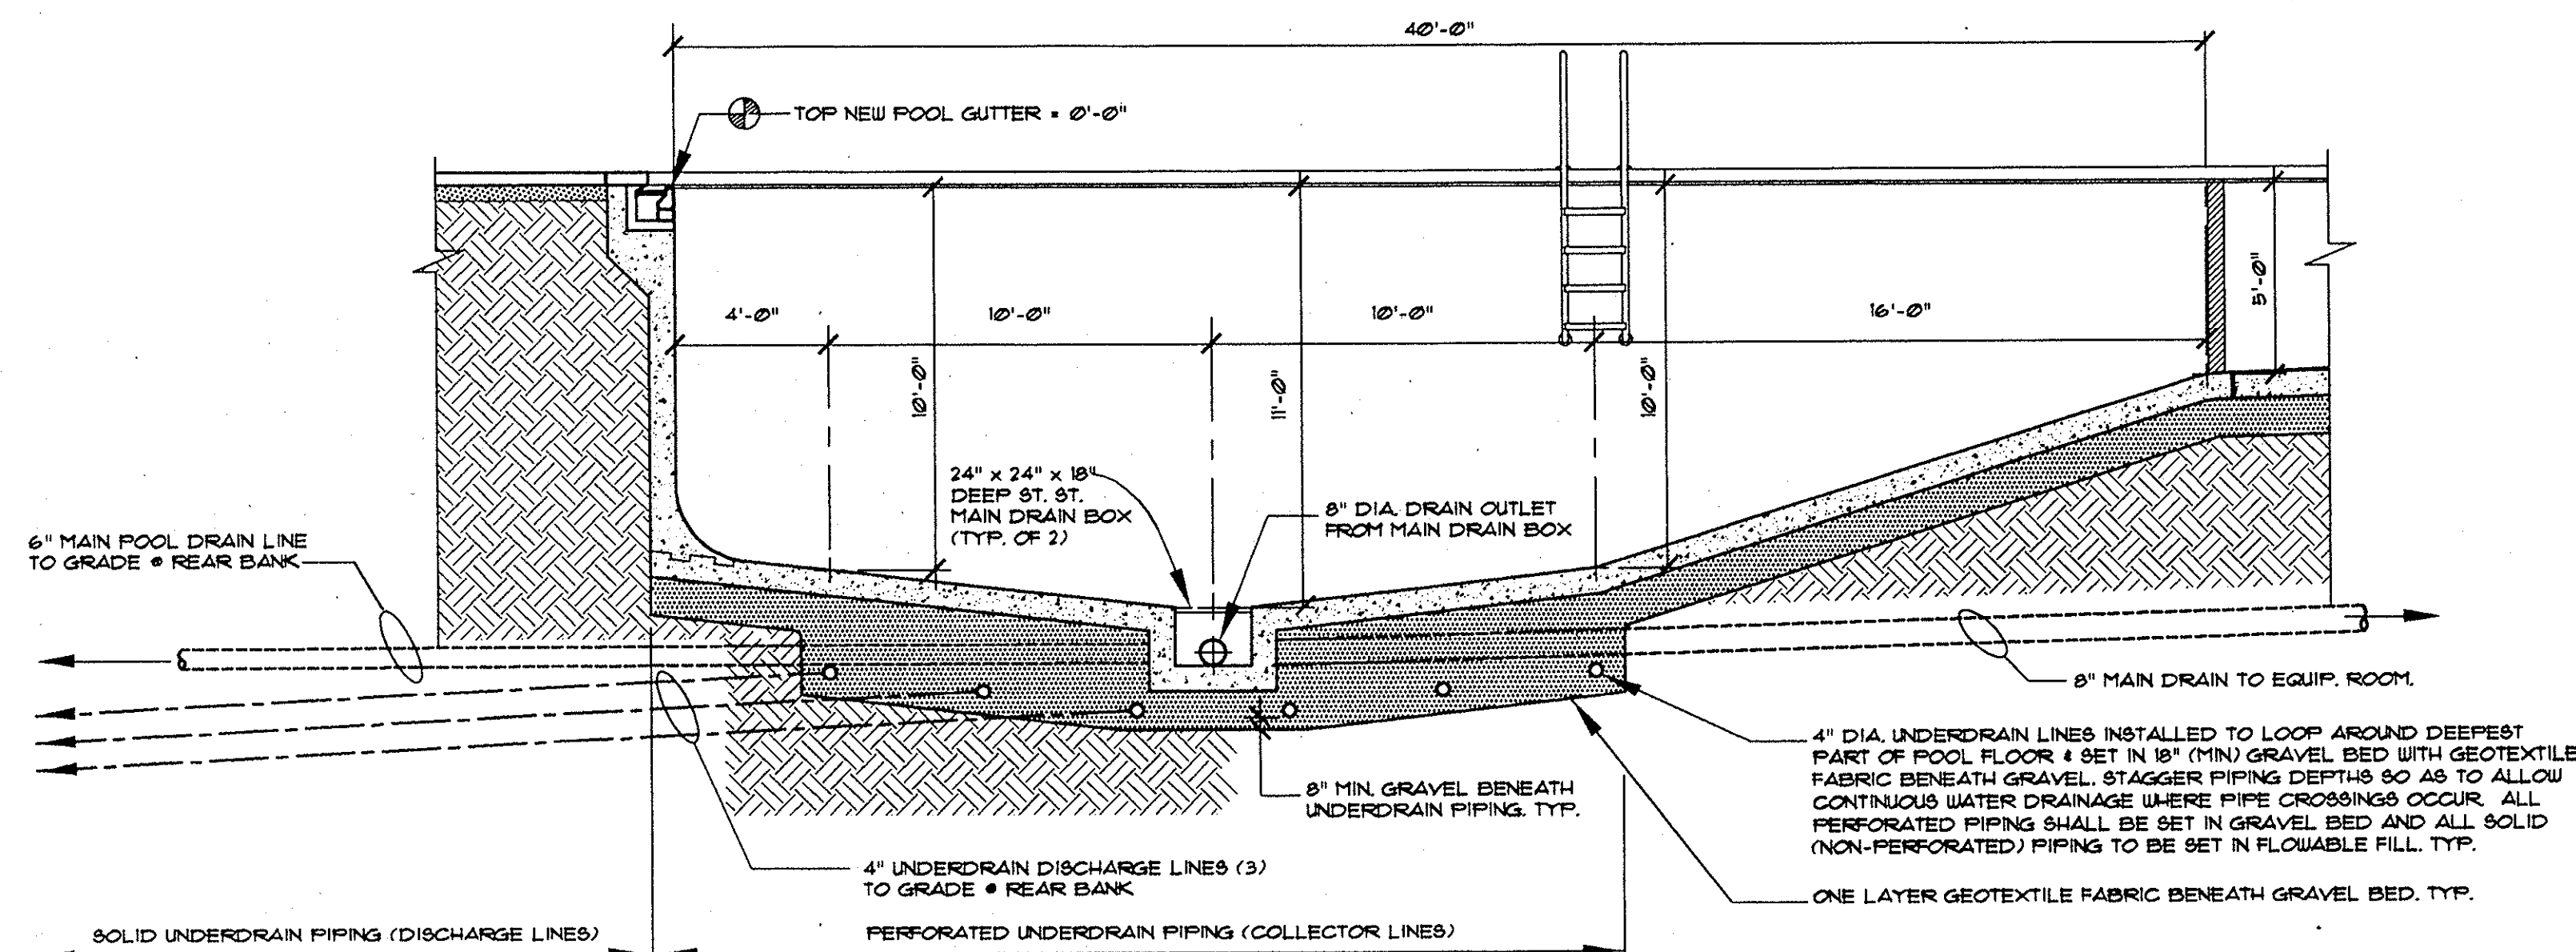

POOL UNDERDRAIN SYSTEM

SCALE: 1/4"=1'-0"

FOR PLAN VIEW OF UNDERDRAIN SYSTEM SEE MECH. SHT. M-1.

DISTRIBUTION RECORD:		REVISION RECORD:	
ISSUED TO:	QUANTITY:	DATE:	DESCRIPTION:

planning
associates, inc.
architects

1112 McALLIE AVENUE
CHATTANOOGA, TN. 37404

423-622-5121

REPLACE SWIMMING POOL
NORRIS DAM STATE PARK
LAKE CITY, TENNESSEE
SBC # 126/063-01-97A

DATE: 10/04/00
JOB #: 371
SHEET #: A-3

FILENAME: NOR-A3
PLOT: 1/4"=1'-0"
AS-BUILT