




POOL EQUIPMENT RM DEMOLITION PLAN
SCALE: 1/4"=1'-0"

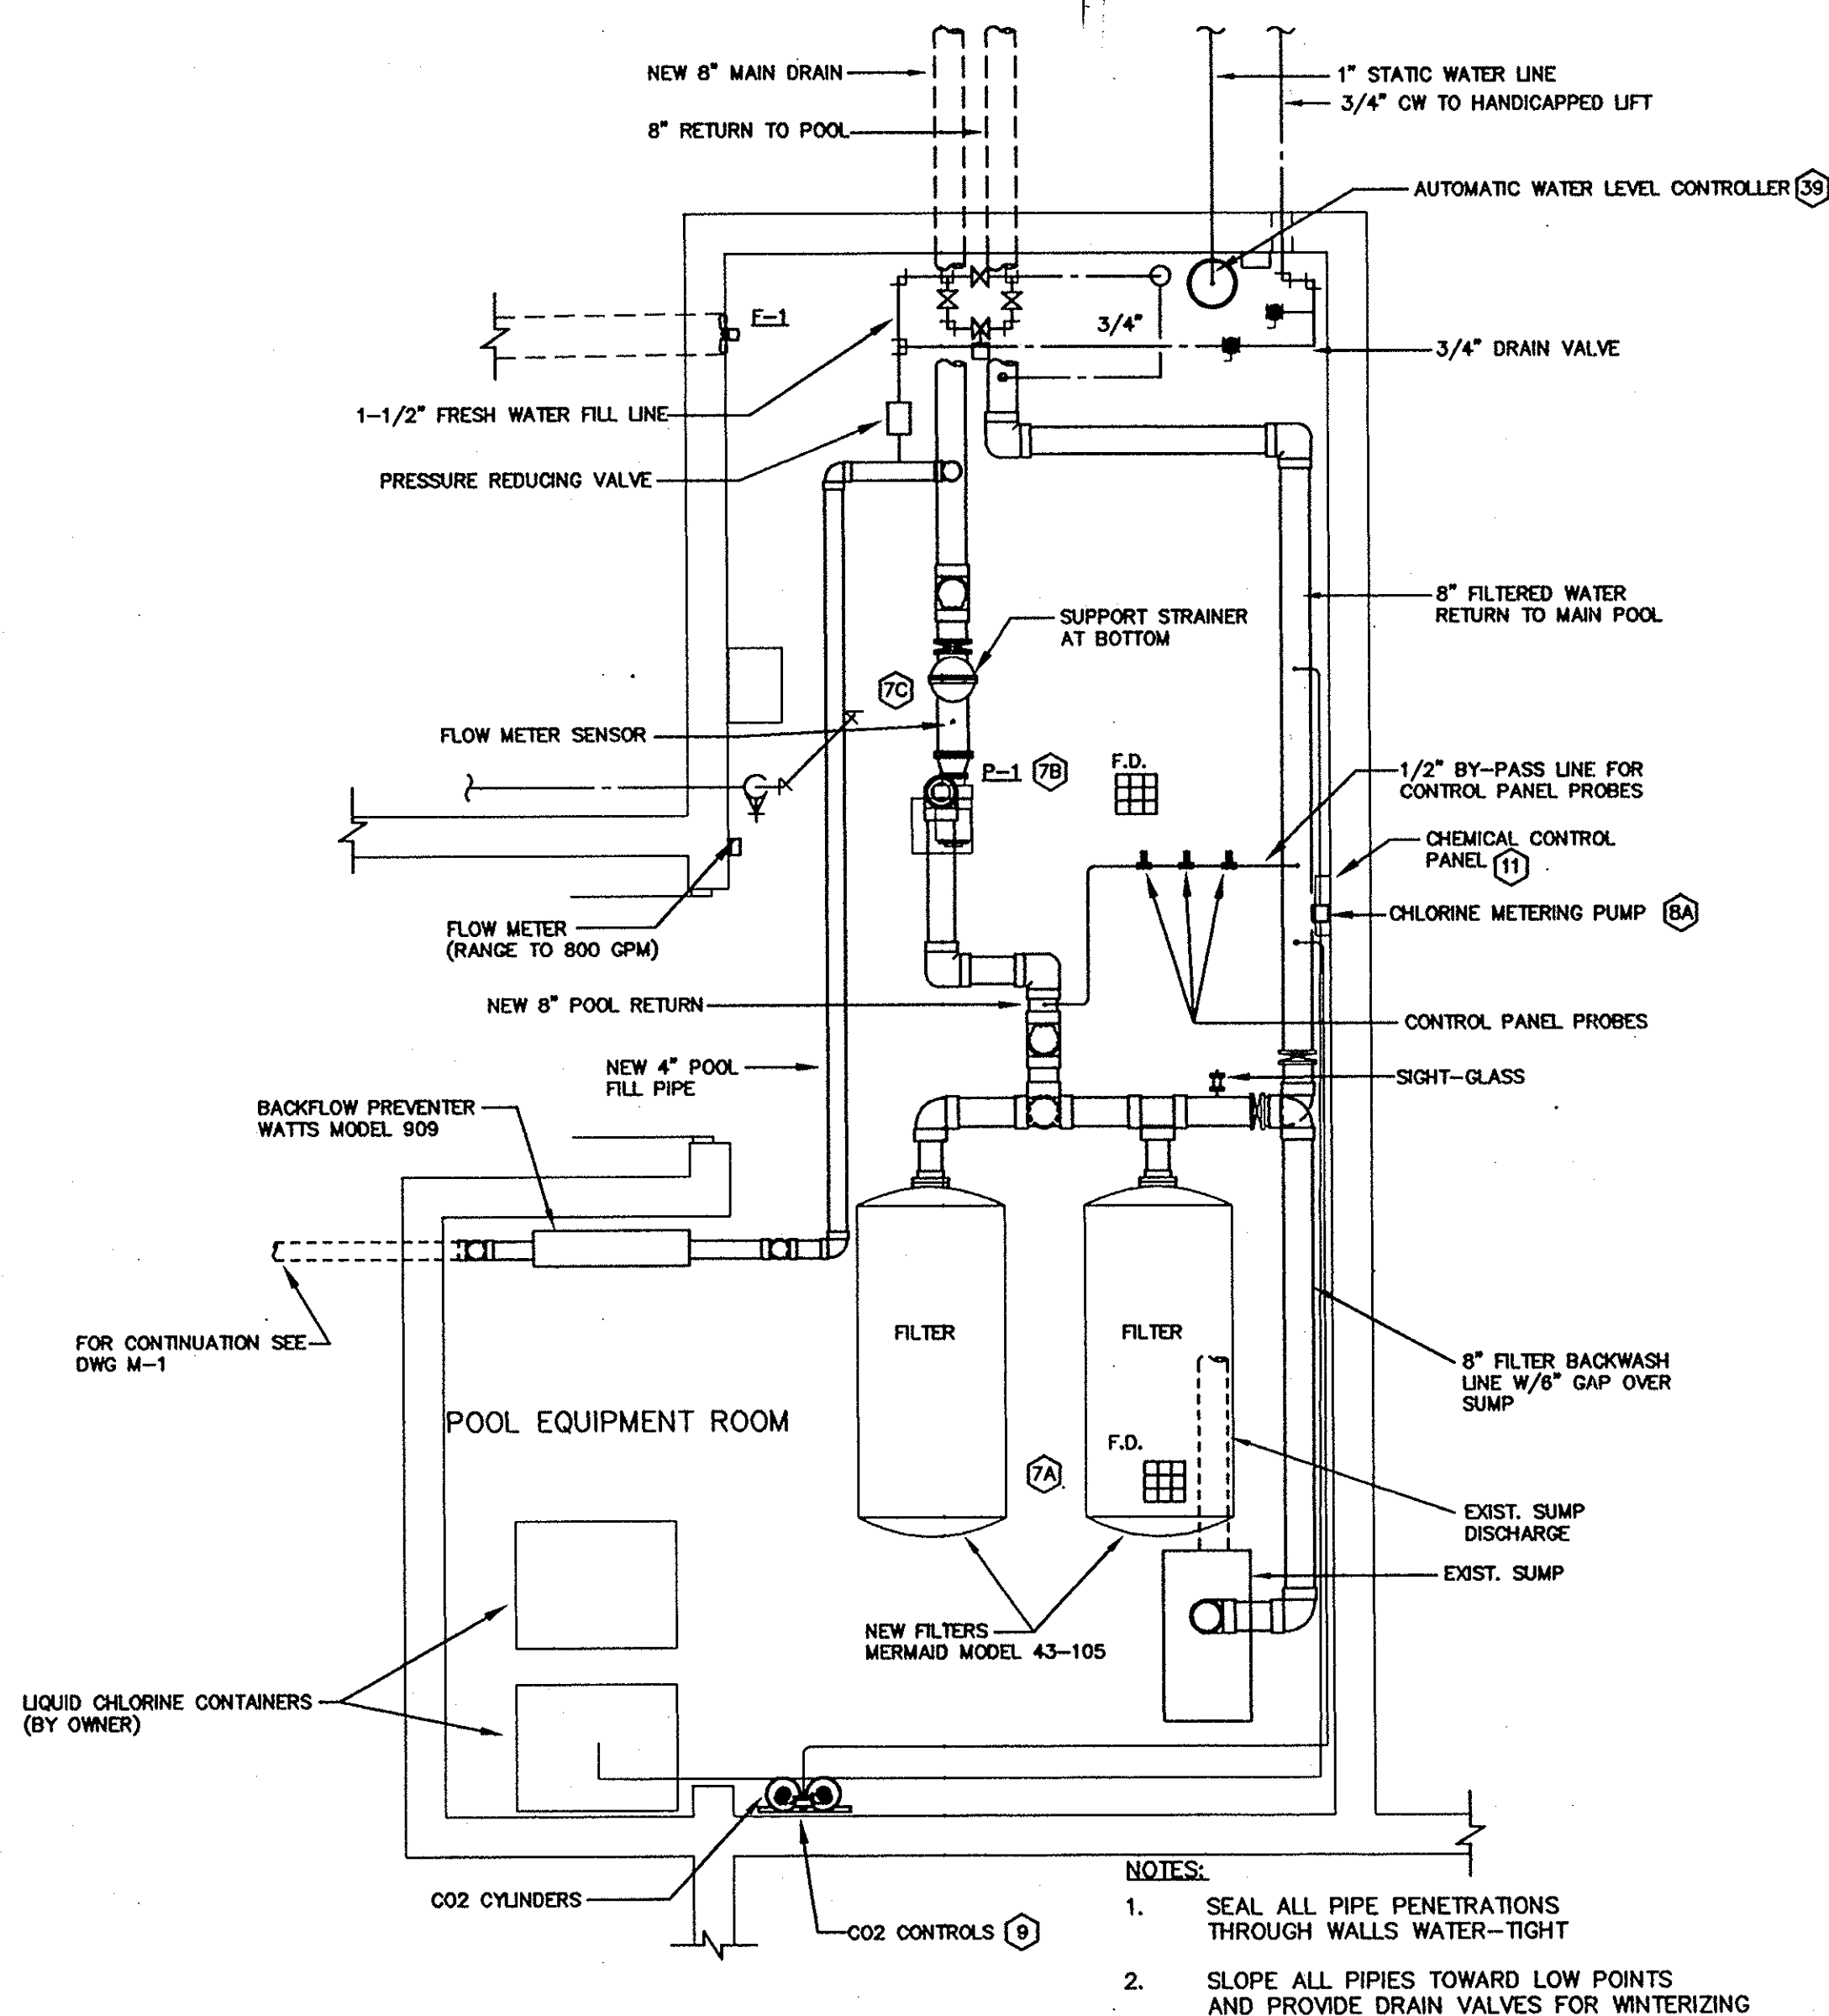


NEW POOL EQUIPMENT PLAN
SCALE: 1/4"=1'-0"

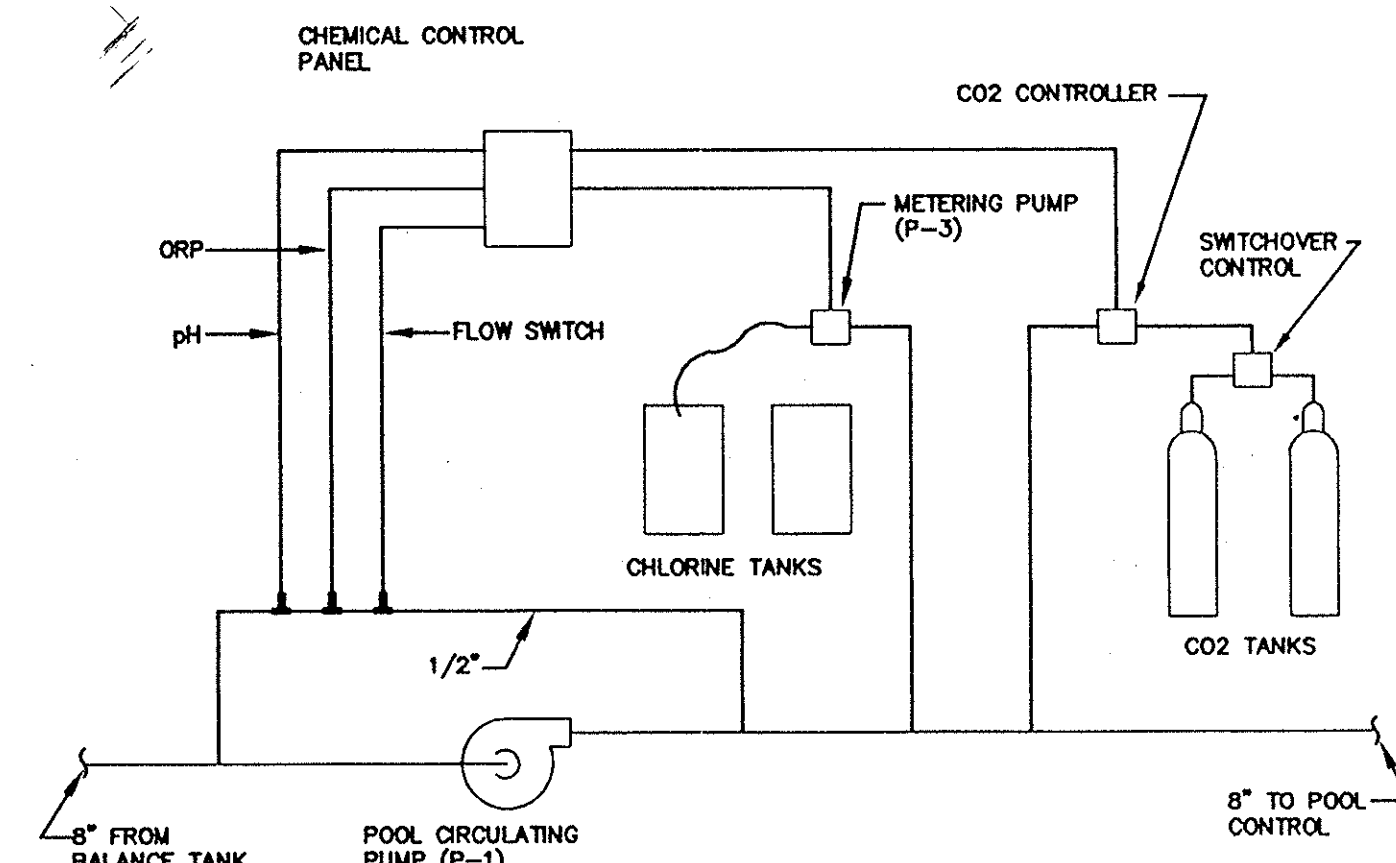

POOL CHEMICAL CONTROL SYSTEM
SCHEMATIC ONLY

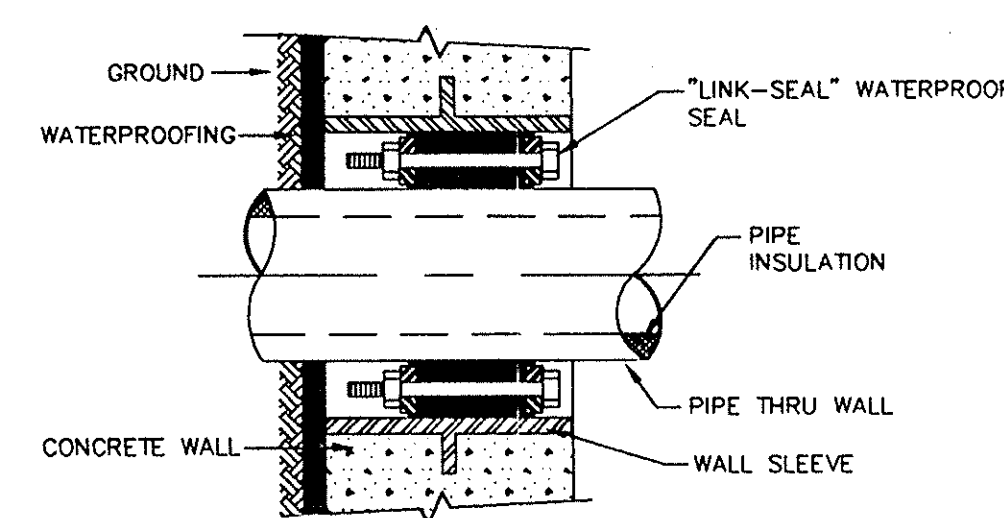

PIPE THRU WALL BELOW GRADE
WATERPROOFING DETAIL
NOT TO SCALE

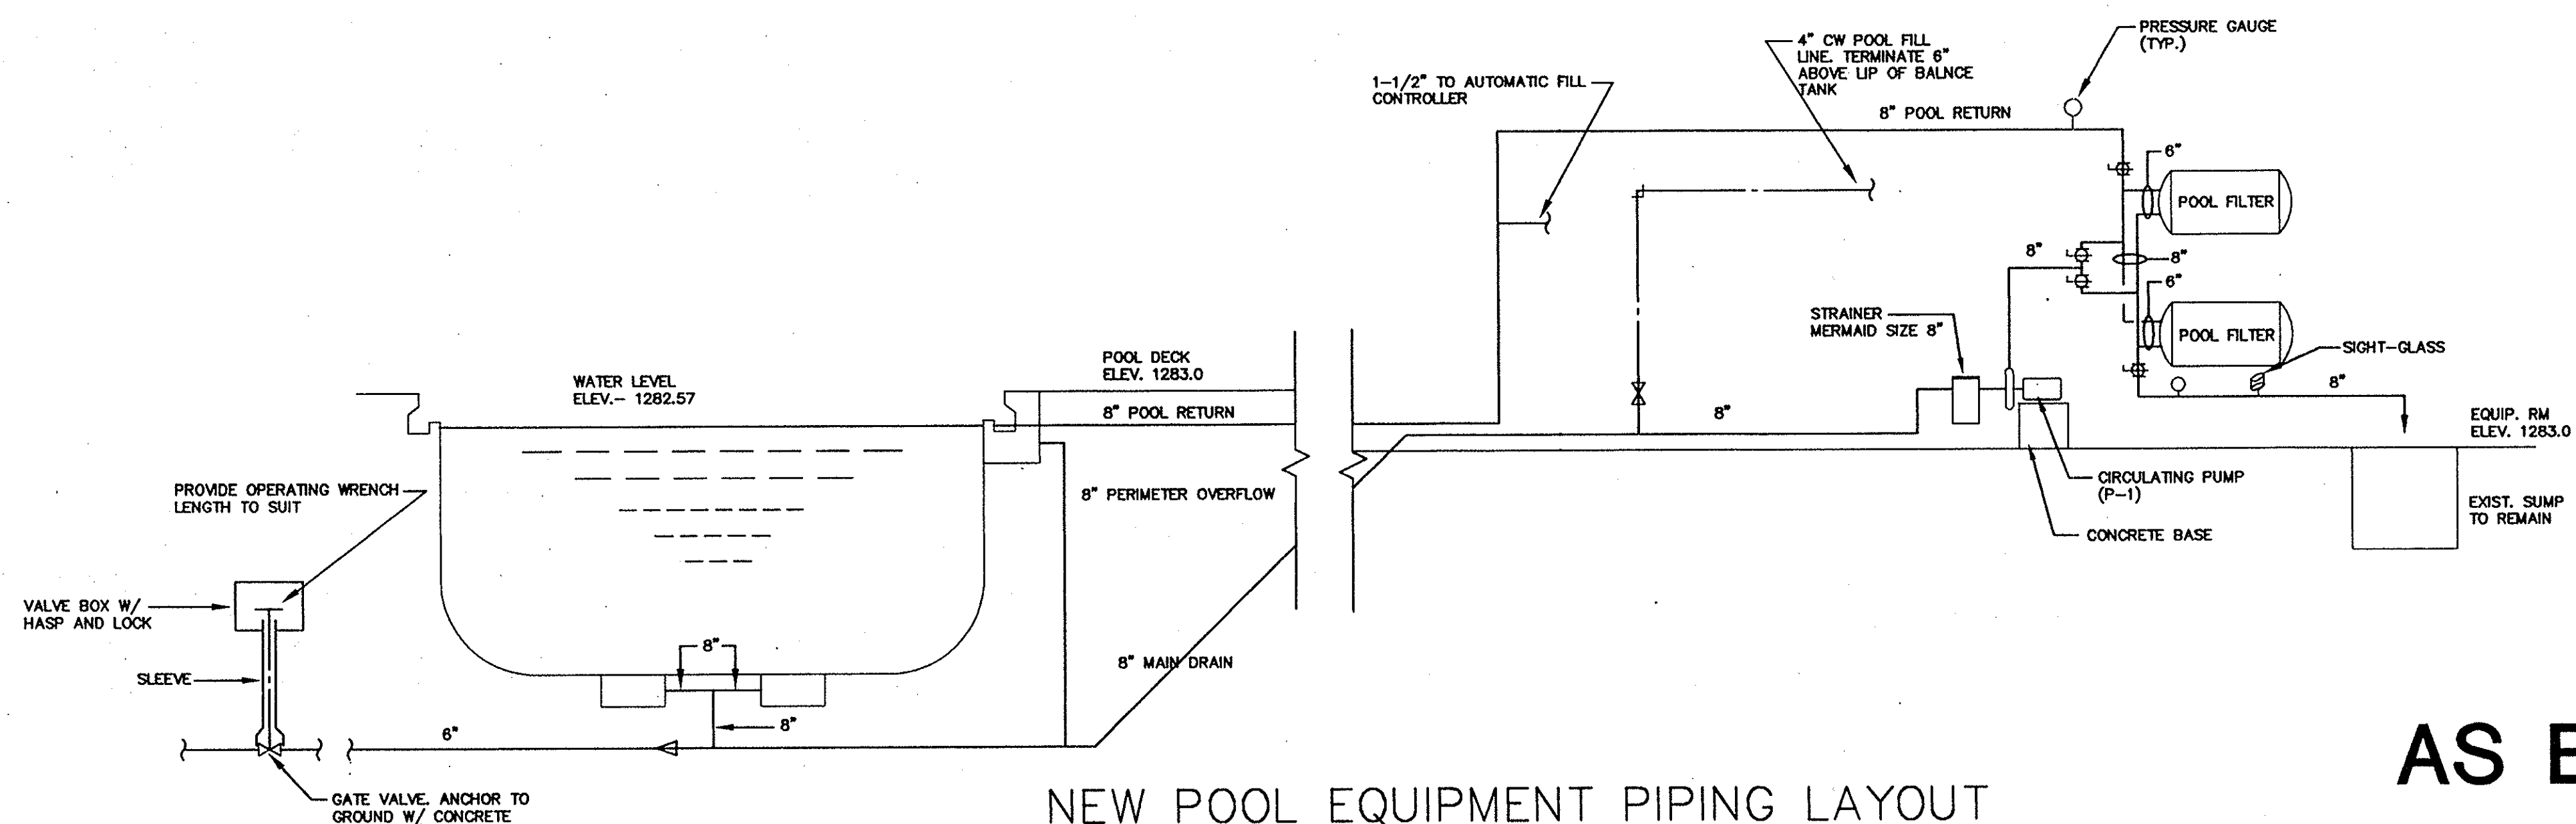

NEW POOL EQUIPMENT PIPING LAYOUT
SCHEMATIC ONLY

AS BUILT

PLOT: 1/4"=1'-0"

Basarrate & Assoc.
Consulting Engineers
Chattanooga, Tennessee

DISTRIBUTION RECORD:		REVISION RECORD:	
ISSUED TO:	QUANTITY:	DATE:	DESCRIPTION:

**planning
associates, inc.**
architects
1112 McCallie Avenue
Chattanooga, TN 37404
423-622-5121

REPLACE SWIMMING POOL
NORRIS DAM STATE PARK
LAKE CITY, TENNESSEE
SBC # 126/063-01-97A

DATE: 10/04/00
JOB #: 371
SHEET #:
M-3
FILE: NOSP43