


EXCAVATION NOTE:
SLOPES & LATERAL LIMITS OF EXCAVATION ARE SHOWN FOR ILLUSTRATIVE PURPOSES ONLY. EXCAVATION SLOPES & STABILITY ARE THE RESPONSIBILITY OF THE CONTRACTOR & SHALL BE IN ACCORDANCE WITH OSHA STANDARDS. LATERAL LIMITS OF EXCAVATION WILL VARY WITH DEPTH & WILL BE DETERMINED BY GEOTECHNICAL ENGINEER AT TIME OF EXCAVATION.

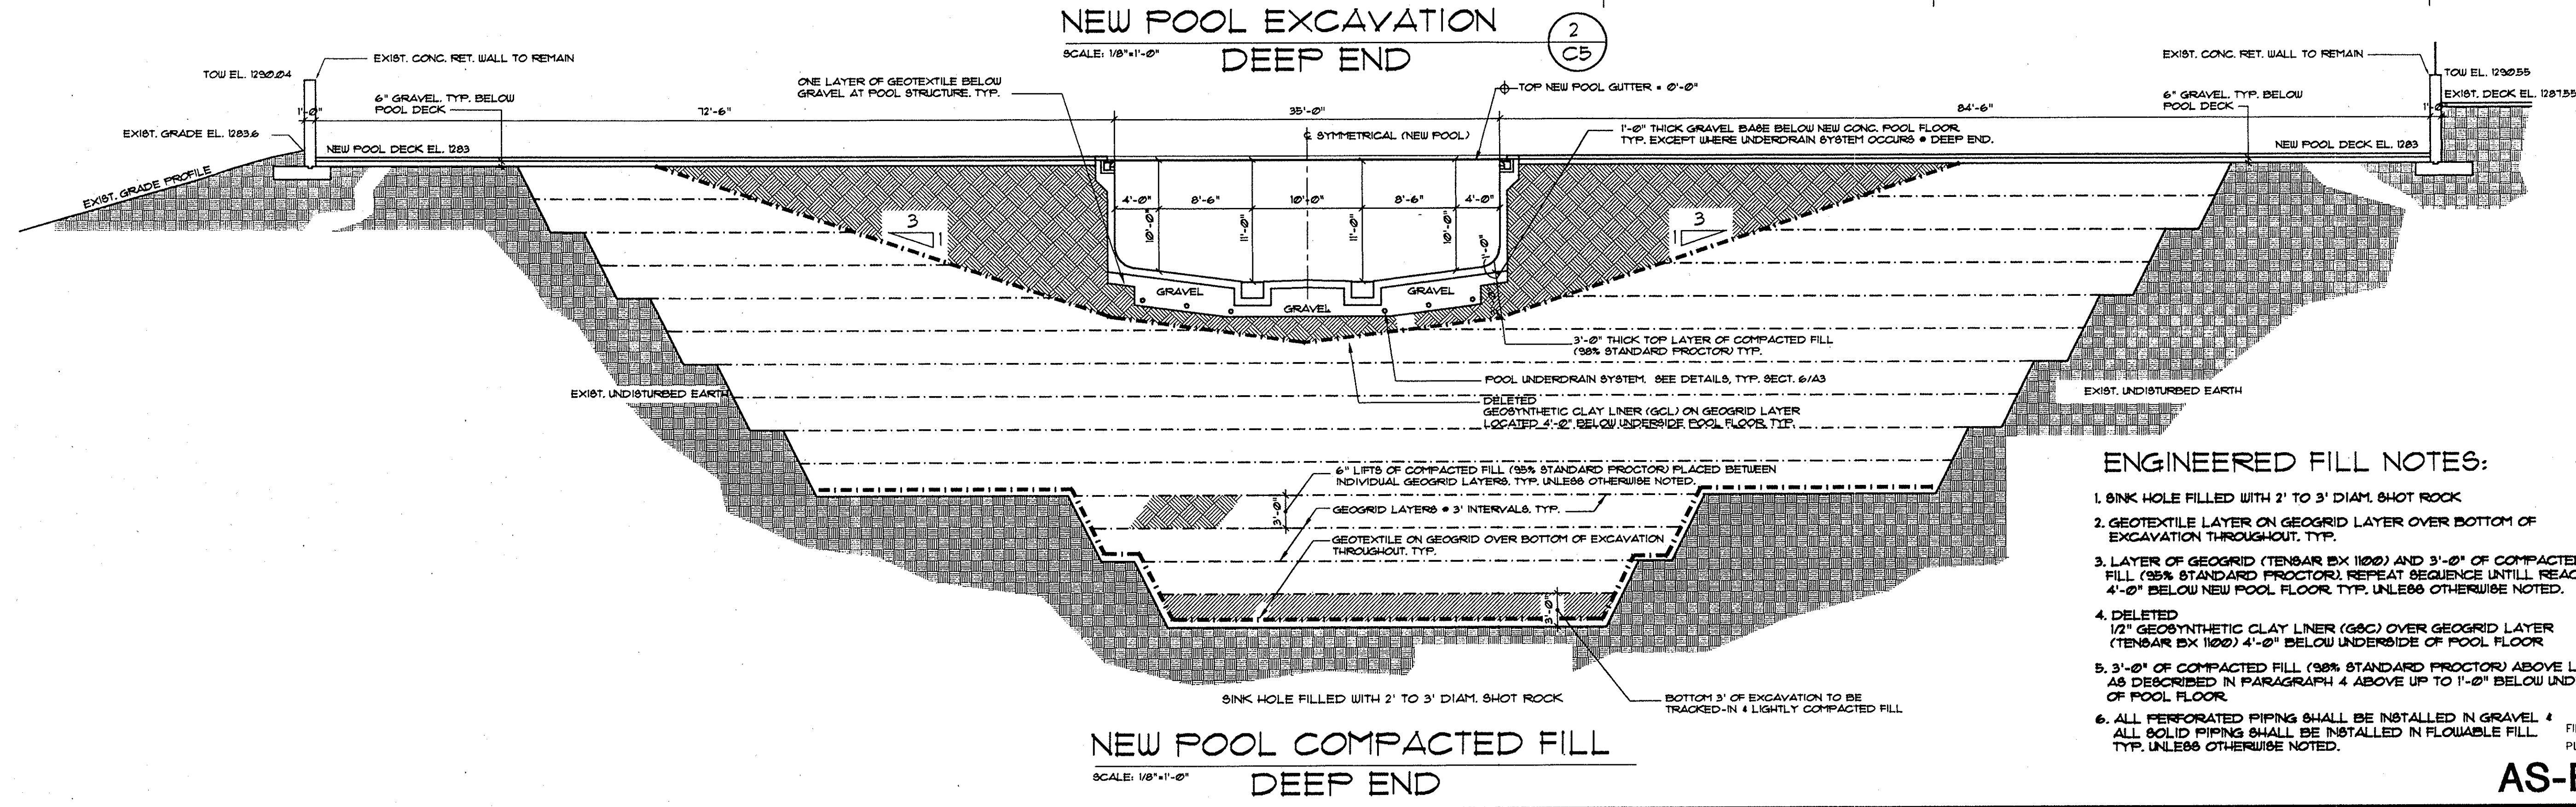

ENGINEERED FILL NOTES:

1. SINK HOLE FILLED WITH 2' TO 3' DIAM. SHOT ROCK
2. GEOTEXTILE LAYER ON GEOGRID LAYER OVER BOTTOM OF EXCAVATION THROUGHOUT. TYP.
3. LAYER OF GEOGRID (TENSAR BX 1102) AND 3'-0" OF COMPACTED FILL (95% STANDARD PROCTOR). REPEAT SEQUENCE UNTIL REACHING 4'-0" BELOW NEW POOL FLOOR. TYP. UNLESS OTHERWISE NOTED.
4. DELETED 1/2" GEOSYNTHETIC CLAY LINER (GCL) OVER GEOGRID LAYER (TENSAR BX 1102) 4'-0" BELOW UNDERSIDE OF POOL FLOOR
5. 3'-0" OF COMPACTED FILL (95% STANDARD PROCTOR) ABOVE LAYER AS DESCRIBED IN PARAGRAPH 4 ABOVE UP TO 1'-0" BELOW UNDERSIDE OF POOL FLOOR.
6. ALL PERFORATED PIPING SHALL BE INSTALLED IN GRAVEL & ALL SOLID PIPING SHALL BE INSTALLED IN FLOWABLE FILL. TYP. UNLESS OTHERWISE NOTED.

AS-BUILT

DISTRIBUTION RECORD:		REVISION RECORD:	
ISSUED TO:	QUANTITY:	No.	DESCRIPTION:

planning
associates, inc.
architects
1112 McALLIE AVENUE
CHATTANOOGA, TN 37404
423-622-5121

REPLACE SWIMMING POOL
NORRIS DAM STATE PARK
LAKE CITY, TENNESSEE
SBC # 126/063-01-97A

DATE: 10/04/00
JOB # 371
SHEET #:
C-5