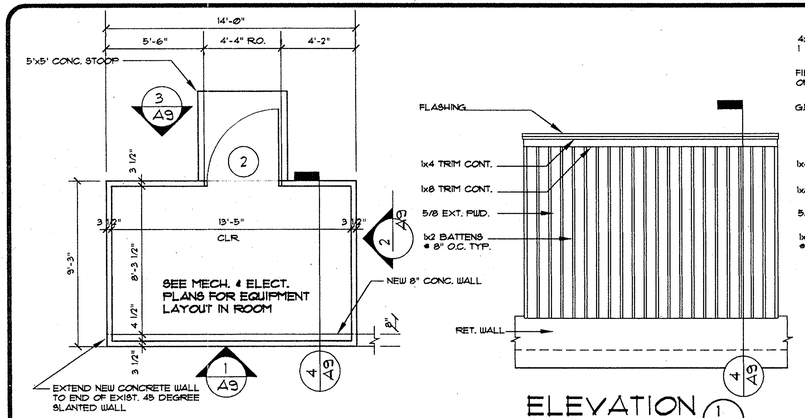

BABY POOL EQUIP. ROOM

SCALE 1/4"=1'-Ø"

NOTES:
1. INSTALL CAULKED JOINT BETWEEN NEW WALL & EXIST. WALL TO REMAIN.
2. SLOPE FINISH GRADE TO DRAIN AROUND BUILDING.

ELEVATION 1 A9
SCALE 1/4"=1'-Ø"

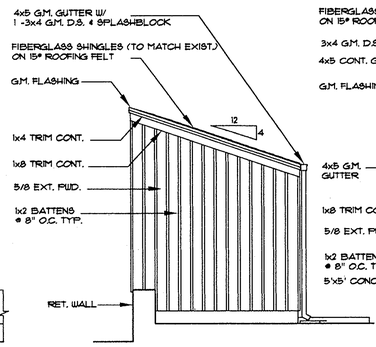

ELEVATION 2 A9
SCALE 1/4"=1'-Ø"

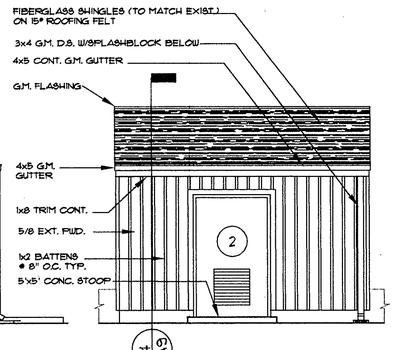

ELEVATION 3 A9
SCALE 1/4"=1'-Ø"

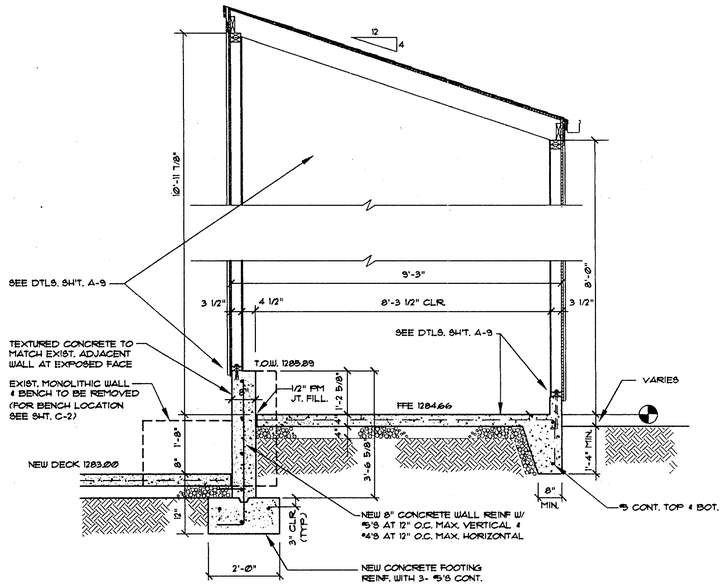

BABY POOL EQUIP. ROOM SECTION 4 A9
SCALE 1/2"=1'-Ø"

DOOR SCHEDULE

DOOR No.	DOOR SIZE	DOOR TYPE	FRAME	THRESH.	HARD-WARE	GRILLE
1	PR. 3'-Ø" x 6'-8" x 1 3/4"	A	1	NONE	1	24" x 24"
2	4'-Ø" x 6'-8" x 1 3/4"	B	2	NONE	2	24" x 24"

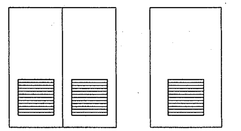

A PR. FLUSH LOUVERED METAL B FLUSH LOUVERED METAL

DOOR TYPES

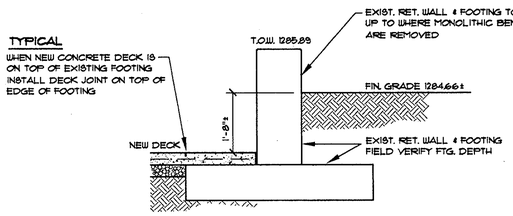

EXIST. RET. WALL SECT. ADJACENT TO BABY POOL EQUIPMENT ROOM
SCALE 1/2"=1'-Ø"

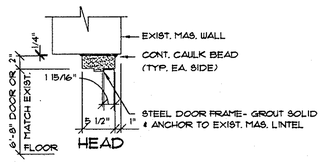

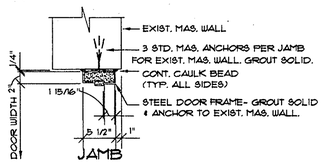

FRAME TYPE 1

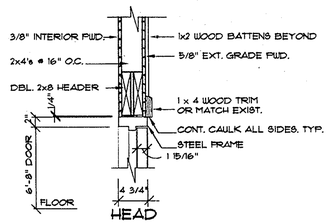

FRAME TYPE 2

DOOR FRAME TYPES

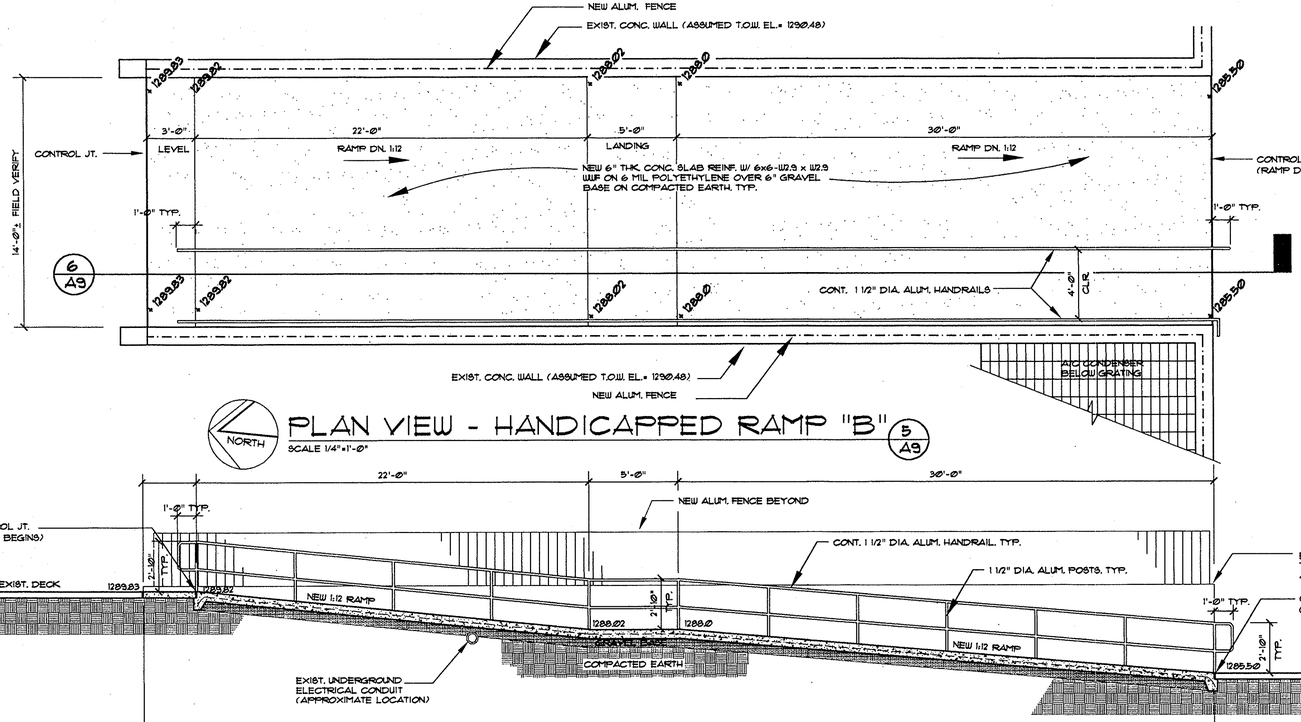

PLAN VIEW - HANDICAPPED RAMP "B" 5 A9
SCALE 1/4"=1'-Ø"

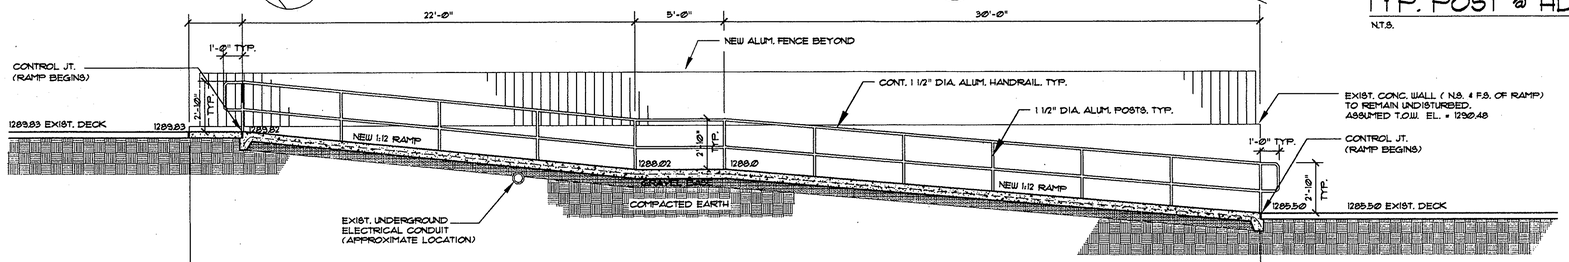

SECTION - HANDICAPPED RAMP "B" 6 A9
SCALE 1/4"=1'-Ø"

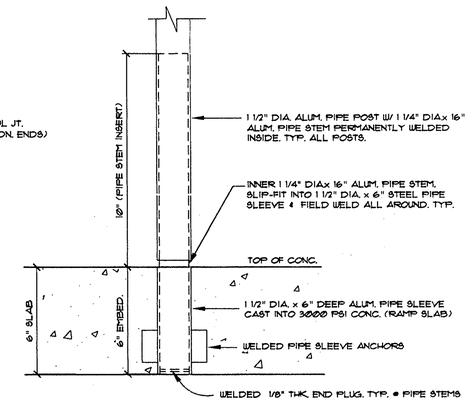

TYP. POST @ HDCP. RAMPS 7 A9
N.T.S.

FILENAME: NOR-A9
PLOT: 1/4"=1'-0"

AS-BUILT

DISTRIBUTION RECORD:

REVISION RECORD:

No.	DESCRIPTION:	DATE:

ISSUED TO: | QUANTITY: | DATE:

planning associates, inc.
architects
1112 McCALLIE AVENUE
CHATTANOOGA, TN. 37404
423-622-5121

REPLACE SWIMMING POOL
NORRIS DAM STATE PARK
LAKE CITY, TENNESSEE
SBC # 126/063-01-97A

DATE: 10/04/00
JOB #: 371
SHEET #: A-9

C:\Projects\371-Norris\371-A9.dwg Mon May 06 13:15:37 2002